

#10-038

Park City-County Environmental Health Department
Individual Wastewater Treatment System Permit Application
(Revised December 2008)

RECEIVED
MAY 28 2010

Part I: Owner Information

Property owner name: BARBARA Timms-WALKER
Complete mailing address: P.O. Box 96
PRAY MT 59065
Telephone: Home 406 224 0435 Work/cell: SAME

Property Owner Timms-Walker Barbara
S 25 T 5 N of S R 8 E
Date Issued 6/1
Date Installed 6/1

Part II: Property Information (Provide Tax information as proof of ownership)

Acreage or dimensions of parcel: 0 acres COS # _____
Legal description of property: Section 25 Township 5 Range 8 PLAT 196
Physical address: #2 PRAY RD, PRAY MT 59065
Is parcel in a subdivision? Yes No

If Yes: You MUST complete this section and include the following documents:

- _____ a copy of the certificate of plat approval statement
- _____ a copy of the state approved lot layout

Name of Subdivision _____
Block and/or lot number _____
EQ or COS# _____ Approval Date _____
Physical location and directions: _____

Septic Permit Number 10-038

Number of bedrooms: # 10-038
Wastewater design flow: 314 gpd Tank(s) required: Existing 1000 gallon tank
Drainfield: Existing 384 ft² of drainfield (64' x 3 lots x 2' wide)

Special requirements:
Change in use from 2010 -> System is now permitted for (1) 3-bedroom single family dwelling and (1) employee of the Post Office.

Approved by Craig Cass RS.
Park County Environmental Health

Issue Date 3/15/18 Expiration Date 3/15/18

This is a permit to install a septic system. The Park County Environmental Health Dept. must be reached to schedule an inspection before the septic system can be backfilled. After the system is approved, this becomes the permit to operate the septic system. No changes can be made to the approved plans and specifications without written approval from Park County Environmental Health. =>

300 gpd
+ 14 gpd

314 gpd

vs.
+ 150
+ 225
+ 13

388 gpd

6 Acre lot

New system is sized for a bathroom to be installed at a later date in the old pig store.






Well
100'
End of post office

Bar-b-walker #2 Piggy pig Piggy mt.

Property line

A.S. Built By
Jim's Backhoe & Septic Service
222-0025 6/7/2010

East River Road

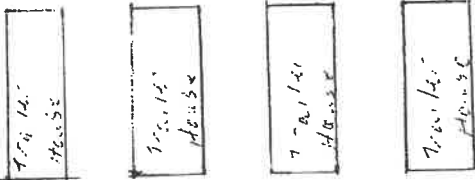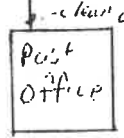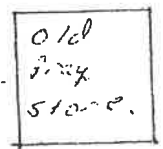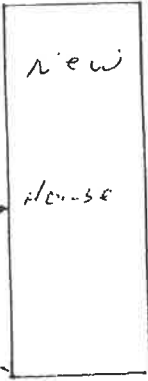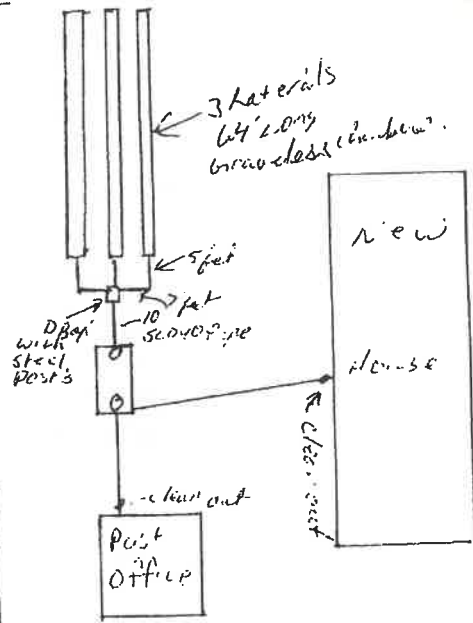

SEWER
AUG 27 2011



Plan sheet