

6926000

APPLICATION FOR INDIVIDUAL SEWAGE DISPOSAL INSTALLATION PERMIT

Park City-County Health Department. Date 120276

10/12/1976

Owner TAVNER J WALKER (Location, lot, block, etc.)

Address PRAY. behind store

New Existing Installer _____

living units 3, bedrooms 4, people served 8, water supply Well
garbage disposal NO, size of septic tank 1000 gallons, drain field

modified drain field _____, seepage pit _____, make or dimensions
of septic tank HOME MADE, footage effective area 28x15 call disposal into


septic tank YES, bypass NO, distance from septic tank to founda-
tion 10 FT, well 600 FT, canal, stream, lake, etc. 500, distance from

drainfield or seepage pit to: well 600, nearest property line 10 FT.
canal, stream, lake, etc. _____, percolation test 290 soil type hard & gravel

GRAVEL ^{with top soil} maximum ground water depth during high water 160 FT

from surface.

Sketch house, proposed sewage disposal layout and all adjacent wells within 200 feet of streams, lakes, etc. X well

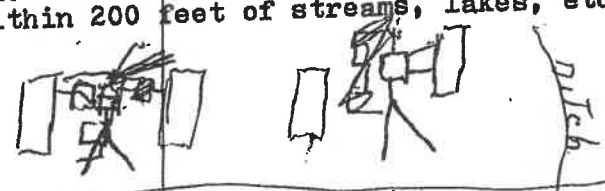

This system will be constructed in accordance with the above specification and regulation governing sewage systems with the county and state. Final inspection must be made before backfill.

Applicant Tavner Walker Address Pray Mt.

Paid Permit No. 709 Bill _____ No Fee _____ Date of Installation _____

Approved Not Approved _____

Date of Inspection 8 March 1976 11/8/1976

By: Ray Helms
City-County Sanitarian -or-
Health Officer

1976

MUST BE INSPECTED BEFORE COVERING